


SUPERVISION COPY

328'4"

267681

WORK CARRIED OUT TO THIS PLAN.

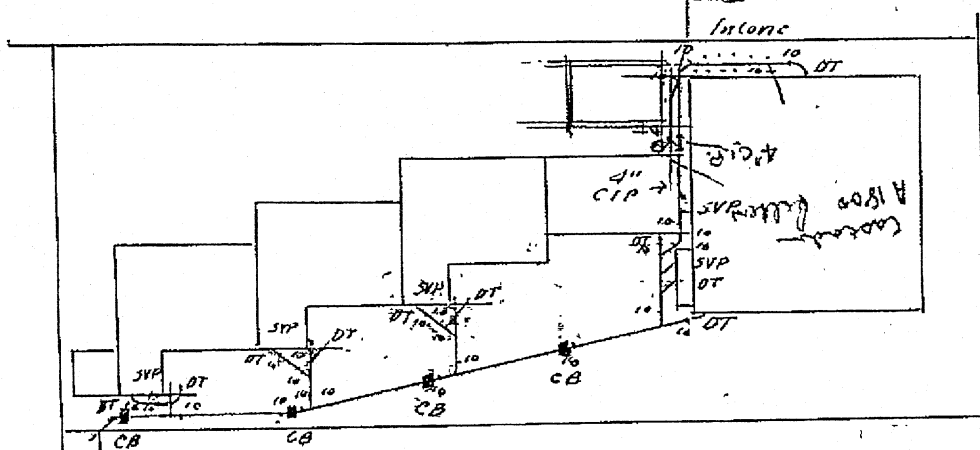

298'3"
30' 94.79

ST.

N

77.30 x 1 HILL 91.99

159'0"

66518

180'

Drains amended as shown in green
WORK CARRIED OUT TO THIS PLAN.

27 SEP 1955

ST. Inspecting Officer.

Tap apron provided to G.D.T. STRUAN
All C.I.P. to be supported to the satisfaction of the Boards.
Pipes under building to be surrounded with 6" of cement concrete.
D.T. branch to fixture No. 15 to be kept under 20'
Basin No. 7 to be connected to SVP by means of 4" x 2" junction
as for Combined Pipe System. CONCRETE BLOCKS TO BE PROVIDED AROUND
Water Service: PIPES, NOT MORE THAN 50 FEET APART
Board requires that the 4 flats be supplied by a single metered WHERE GRADE IS STEEPER THAN 1 IN 15.
service (1 1/2" approved on corres. 53/3354).
Separate controlling stop tops are to be fixed on the vertical risers
each group of fittings.

MELBOURNE AND METROPOLITAN BOARD OF WORKS PLAN OF HOUSE CONNECTIONS DRAINAGE

WARNING Unauthorised interference with any pipes laid by the Board is forbidden. Offenders are liable to prosecution and penalties as prescribed by the Melbourne and Metropolitan Board of Works Act. 1928.

Scale: 40 feet to 1 inch

Municipality PRAHRAN

Plan No. 267681

For Construction Branch Use Only

Job No.

Corres. No. Folio. No.

MEASUREMENTS

M.H. to Sub. Div.

LS " " "

" " Oblique

Centre of Retie to H.B.V.D.

" " Oblique

" " B Line

Owner Mrs. A. B. Grounds Flat No. 11. 44 Murphy St. Sth. Yarra

REFERENCE


B.T. Boundary Trap
C.I.P. Cast Iron Pipe
D.T. Disconnector Trap
E.V. Educt Vent
G.D.T. Gully Disconnector Trap
G.I.T. Grease Interceptor Trap
G.T. Gully Trap
G.V. Ground Vent

Conditions of Issue

- The whole of the drainage and/or plumbing work shall be carried out in accordance with the By-Laws and requirements of the Board and any special conditions endorsed hereon.
- This plan is issued subject to the Owner accepting all responsibility for the drains indicated by green lines being in the position shown and at a suitable level for the connection thereto of the additional work and for such drains being in good order and condition.
- Position of H.C. branches to be determined by measurements recorded on this plan.

00267681

267681

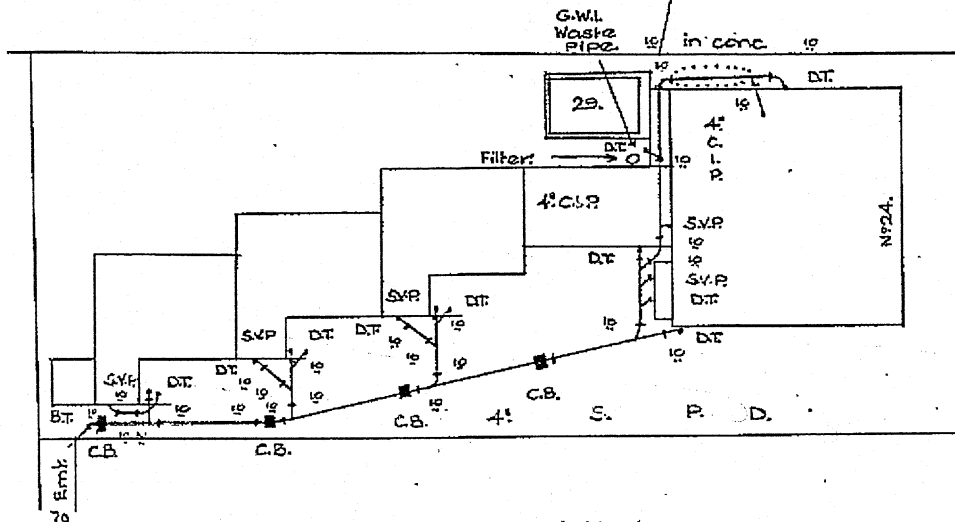

Additional Work.

29. Swimming pool ~~proposed to be~~ emptied by a manually controlled electrically operated pump to discharge to proposed DT. Filtration and recirculating system ~~to be~~ connected in accordance with the Boards requirements and air disconnection ~~to be~~ provided to the satisfaction of the Boards Inspecting Officer.

Drain ~~to be~~ laid shown in blue.

WORK CARRIED OUT TO THIS PLAN

21 JAN 1980

This plan is issued subject to the conditions that.

1. The owner shall accept the risk and responsibility in all things in regard to the installation and operation of the manually controlled electrically operated pump to pump the effluent from the swimming pool to the sewer.
2. The contents of the swimming pool to be discharged to the sewer during night hours (8:00 PM. - 6 AM.) only after a day without rain.

P 9

24 Hill St.

MELBOURNE AND METROPOLITAN BOARD OF WORKS

WARNING: Interference with any drain, sewer, water service pipe or water main without the consent of the Engineer-in-Chief is a breach of the Board's By-Laws for which penalties are provided.

Scale: 40 feet to 1 Inch

MUNICIPALITY... PRAHRAN

Litho. No. 936

Drainage
Plan No. 267681

For Construction Branch Use Only

Job No.

Corres. No. Folio. No.

MEASUREMENTS

M.H. to Sub. Div. }
I.S. " " " }
" " Oblique
Centre of Retic. to H.B.V.D.
" " " " Oblique
" " " " B. Line
" " " " E. P.
Tie to Sub. Div.
Barrel Retic. to Barrel Br.

Designed: G.E.H.

Traced: M.S. 1.1.1.63

Examined: M.M.

Board's Sewer shown by heavy broken lines. H.C. Drains shown by full lines.

OWNER: J.O. R. Grounds.

AGENT: E. Dickson. Filtration & Water Softening Pl. Princess Hwy. J. Springs

Consent is hereby given to for the execution of plumbing work for sewerage and water supply in accordance with this plan and the By-Laws Regulations and Requirements of the Board.

All plumbing work for sewerage and water supply shall be carried out by a plumber licensed by the Board.

House connection drains are to be constructed in accordance with Drawing H.S.A. 1-3. and Instruction. H.S.N. No.94.

Positions of House Branch Sewers are to be determined by measurements recorded on this plan.

267681