



NATIONAL TRUST OF AUSTRALIA (VICTORIA) *new file*

TASMA TERRACE, 4 PARLIAMENT PLACE, EAST MELBOURNE

654 4711

BUILDINGS COMMITTEE

NOTE:

If family papers, diaries, etc., are not available, useful sources of information are the Titles Office, the Municipal rate books, and early Directories at the LaTrobe Library. At least two photographs, 9cm X 11cm of the facade are required to support the historical data. However it should also be photographed from all four sides.

The Trust has limited facilities for research and would appreciate you exploring the above sources as thoroughly as possible before returning this form.

DATA FORM

1. Present Name of Building..... Moonbria
2. Address (Precisely, please: if out-of-town describe location sufficiently to enable a visit: Municipality, Shire or other local Government area).
..... 68. Bathoura Rd. Toorak (City of Prahran)
.....
.....
3. Present Owner.....
4. Present Occupant (If not Owner). Flats.....
5. Date of Original Construction..... 1941.....
- 5(a) See notes on grounds attached.
In Quamby, 3 Glover Crt
+ Clendon Flats
- 6.....
.....
6(a) by
..... recently,
.....
- 7.....
.....
- 7(a)
.....
8. builder.....
- 8(a) Evidence.....

(MOONBRIA FLATS)
68 MATHURA RD. TOORAK

RATE BOOK SEARCH

Date & entry no -	Owner	Occupier	Description	NAV
1942-43	S. Yarra Ward (Toorak Ward)			
No. 3974	Mrs Aubrey Hudson Rutherford (659 Toorak Rd.)	Wayne Genard Clarke (USA Red Cross official)	68 Mathura Rd 2B	£ 76
3975	"	Nancy Swenson (AWAS)	" 2B	£ 76
3976	"	John Hardy (eng.)	" 2B	£ 68
3977	"	Verna Papier (hd)	" 2B	£ 62
3978	"	Dorothy Pastridge (hd)	" 2B	£ 62
3979	"	Mabel Miller (WAAF officer)	" 2B	£ 62
3980	"	Dorothy Anderson (Caretaker)	" 2B	£ 62
↓				
3994.				£ 70 £ 76 £ 70 (mostly £ 68 or £ 70)
(Tenants include. John Arnold Doyle (radio announcer) 39 83 Lance Jack Clementson (airforce officer) 39 84 Peggy Forbes (AWAS 39 85 Clifford Clarke (naval officer) 39 86 Andrews Phillips (airforce officer) 39 88 Hennak Mary Hayes (m. officer) 39 91 Francis Spragge (technical officer) 39 93 Colin Gordon (airman) 39 94. Three shown as owners, Beak, Balmu + Gray				
1941-42	S. Yarra Ward			
No. 3962	Audrey Hudson Rutherford. (659 Toorak Rd)	Misses Rose Marika, Ernestine, Alice M Dietrich (naked)	VL ?	£ 160

Drainage Plan

23328

Sheet No. 973.

PLAN SHOWING RETICULATION TO BE LAID.

Municipality PRAHRAN

SCALE: 40 FEET TO AN INCH.

NOTE

Reticulation laid shown in full red lines
to be laid - broken red lines

Retic. Area No. 53

Sewerage Area No. 42

A. Rutherford. 579 Toorak Rd. Toorak. Owner.

R. Grounds. Ranelagh. Mount Eliza. Agent.

Extension of Retic. required.
I.L. 59.80. at Boards expense.
(B.T. & shaft to be C.I.P.)


Rise 2"

Dep 9'4"

blay

ML

ORMSBY GVE.

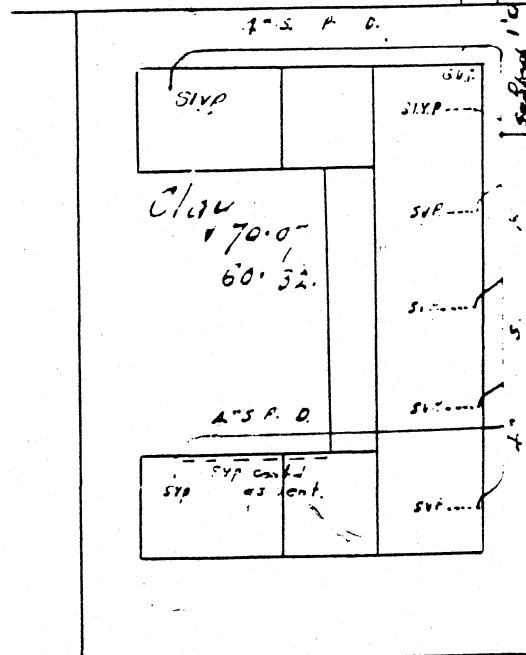

MATHOURA RD.
3" N.M.

5-7-41

Examined, PD

Engineer.

Melbourne,

8/7/1941

Plotted
4/6/48